

RESOLUTION NO. 2022-1660

A RESOLUTION ACCEPTING THE RE-PLAT OF LOT SIX (6), IN BLOCK EIGHT (8) OF ADDINGTON FARMS II, SECTION 1, OKLAHOMA COUNTY, OKLAHOMA, ACCORDING TO THE RECORDED PLAT THEREOF FOR THE PURPOSE OF CORRECTING A SCRIVENER ERROR IN ADDRESSING ON A FILED PLAT AS PROVIDED IN O.S. TITLE 19, §868.8.

WHEREAS, the Oklahoma County Planning Commission did on April 21, 2022 in an open meeting approve the **re-plat** of Lot 6, in Block 8, of Addington Farms II, Section 1 an addition to Oklahoma County, Oklahoma

Location: NW 220th & Pennsylvania Ave. (County Highway District #3)

And

WHEREAS, the Planning Commission recommends approval by the Board of County Commissioners

NOW, THEREFORE, BE IT RESOLVED that the Board of County Commissioners hereby accepts this **re-plat** of Lot 6, in Block 8, Addington Farms II, Section 1 and authorizes the address change from 22559 to **22589 Forester Lane** be placed on record.

APPROVED this _____ day of _____, 2022

BOARD OF COUNTY COMMISSIONERS
OKLAHOMA COUNTY, OKLAHOMA

APPROVED:

Stacey Trumbo, P.E.
County Engineer

_____, Chairman

_____, Member

_____, Member



ATTEST:

David B. Hooten,
County Clerk

APPROVED as to form and legality this _____ day of _____, 2022

Gretchen Crawford, Assistant District Attorney

OKLAHOMA COUNTY PLANNING COMMISSION
 RE-PLAT (RE-2022-01) ADDINGTON FARMS II
 SEC 1
 LOCATION: NW 220TH & PENN 290.00'
 APPLICANT: CRAFTON TULL

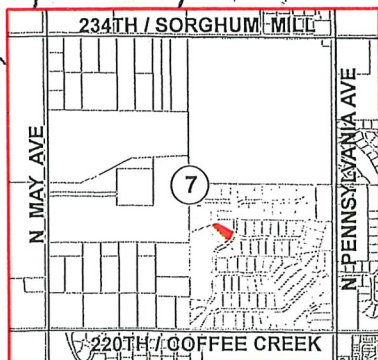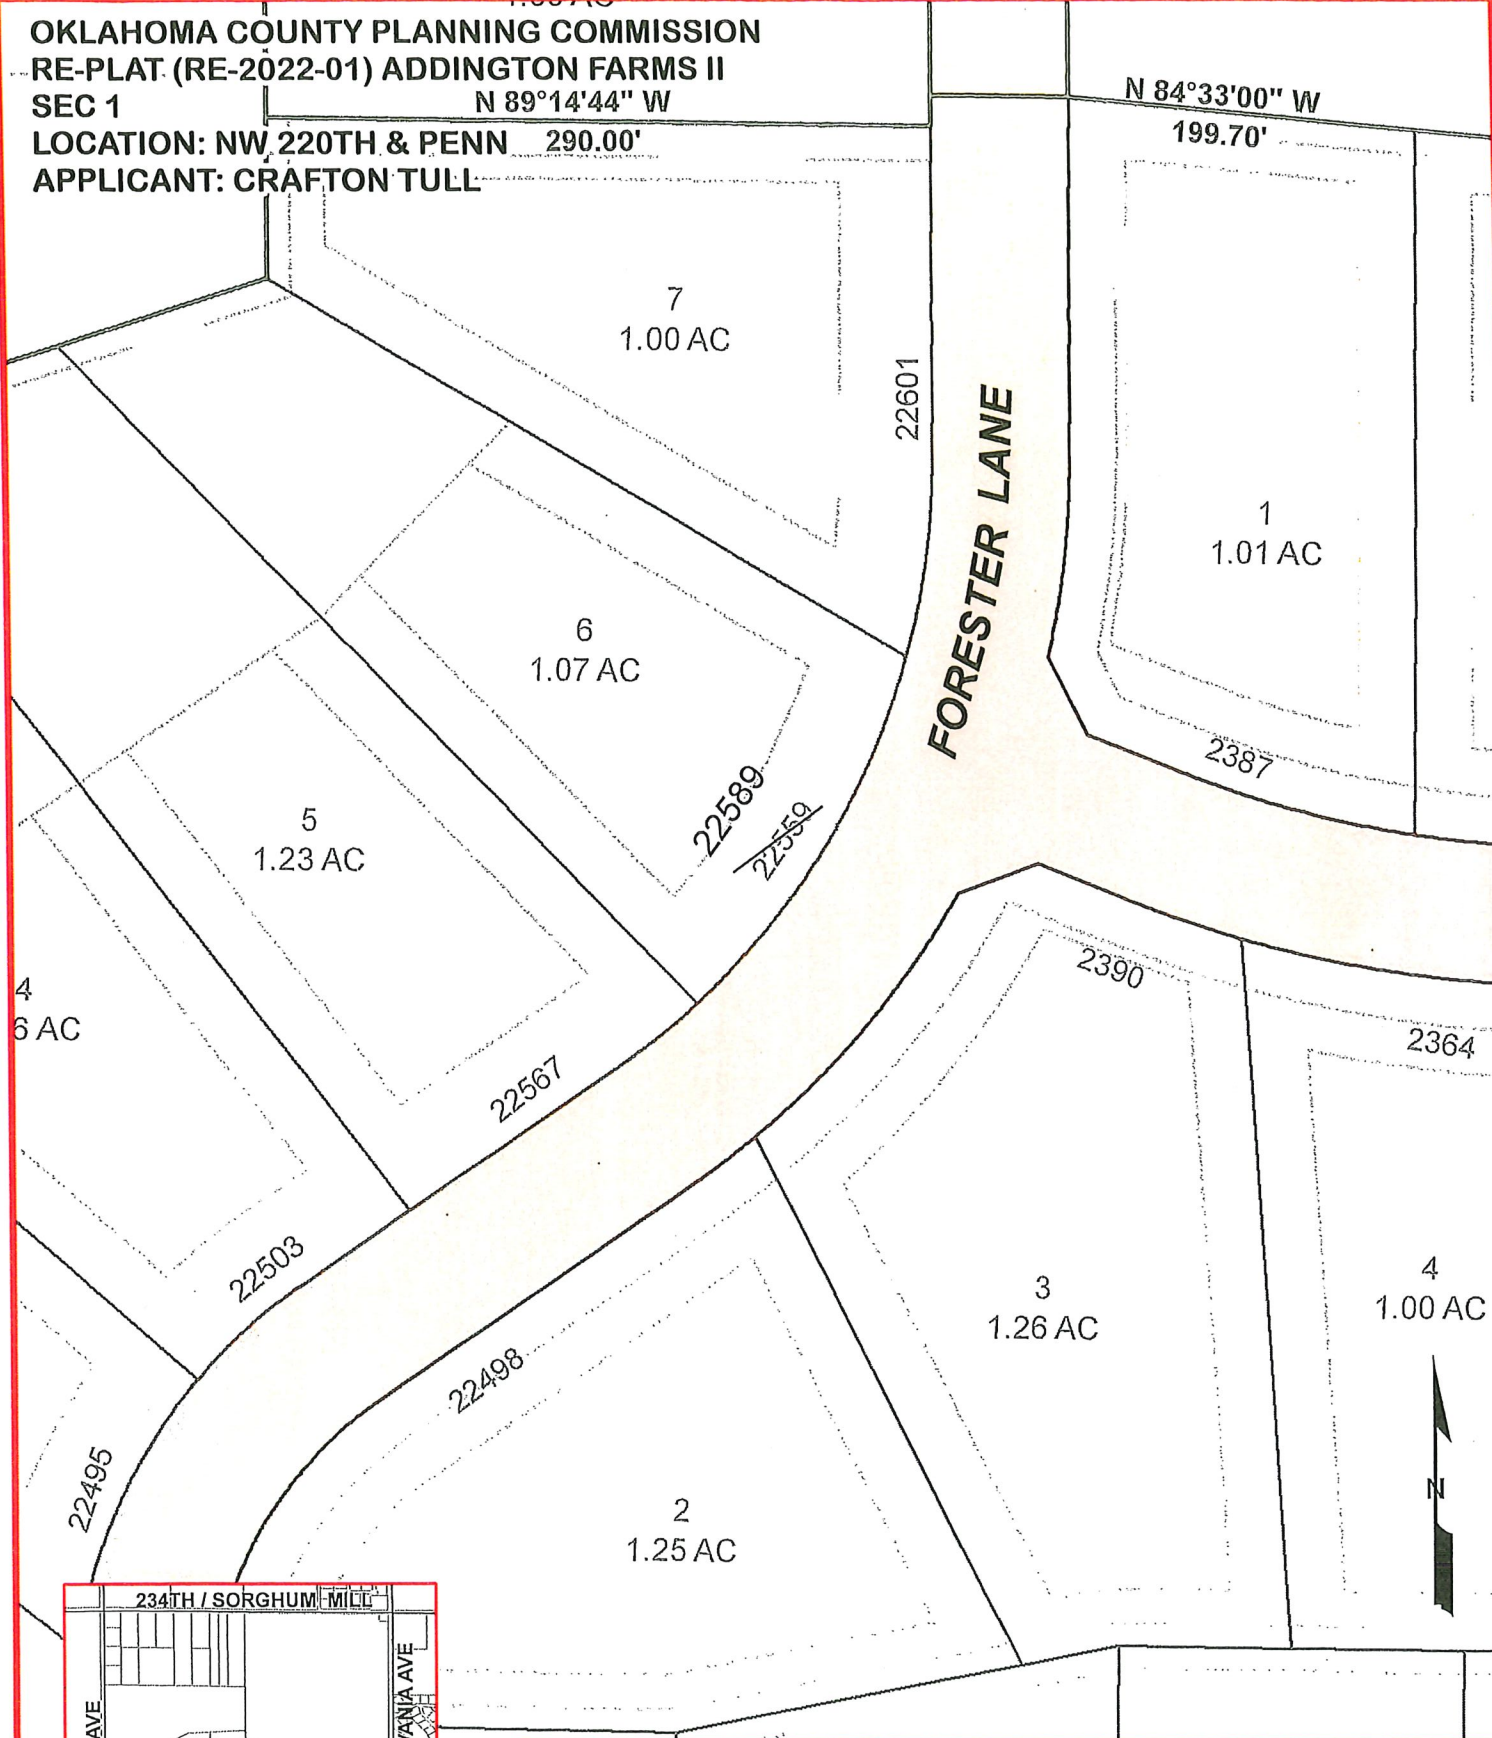

SECTION 7, T-14-N, R-3-W, 1.M
LOCATION MAP



**OKLAHOMA COUNTY
 ENGINEERING & PLANNING**

320 Robert S. Kerr, Suite 201
 Oklahoma City, Ok 73102-3431
 County Engineer : Stacey Trumbo, P. E.

Date:
 FEB 2022

Scale:
 NO SCALE

Drawn By:
 SCM

**OKLAHOMA COUNTY
BOARD OF COUNTY COMMISSIONERS**

AGENDA ITEM REQUEST SHEET

FOR THE May 16, 2022 AGENDA

DEPARTMENT: Planning REQUESTED BY: Tyler Gammon

REQUISITION NO.: _____ REQUISITION SHEET ATTACHED: _____ YES X N/A

NAME OF FUNDS: N/A

FUND NUMBERS: _____ / _____ / _____

DOES THE AGENDA ITEM CONTAIN PRIVACY-PROTECTED OR SECURITY INFORMATION? _____ YES X NO

AGENDA ITEMS CONTAINING PRIVACY-PROTECTED OR SECURITY INFORMATION WILL NOT BE HYPERLINKED TO THE AGENDA.

NUMBER OF ORIGINAL DOCUMENTS TO BE RETURNED TO YOUR DEPARTMENT: 1

AGENDA ITEM READS AS FOLLOWS: Discussion and possible action regarding approval of Resolution No. 2022-1660 to accept the re-plat (RE-2022-01) of Addington Farms II, Section 1, Lot 6, Block 8, an addition to Oklahoma County, Oklahoma to correct an addressing error on the filed plat as provided in O.S. Title 19§868.8. The Oklahoma County Planning Commission recommended approval during a public meeting on April 21, 2022. Location: NW 220th St. & Pennsylvania Ave (County Highway District #3). This resolution corrects the scrivener's error and authorizes the re-plat to be placed on record. Requested by Tyler Gammon, Planning Director and approved as to form and legality by Gretchen Crawford, Assistant District Attorney.

APPROVED BY DA
(If Applicable)

APPROVED BY ENGINEER
(If Applicable)

APPROVED BY PURCHASING
(If Applicable)

ASSISTANT DISTRICT ATTORNEY

COUNTY ENGINEER

PURCHASING AGENT

Please initial that document has been reviewed for privacy-protected or security information

DISTRICT ATTORNEY: _____ YES X N/A

COUNTY CLERK: _____ YES X N/A

DATE OF REQUEST: May 11, 2022 APPROVED BY: _____
CHAIRMAN

REQUEST FOR DISTRICT ATTORNEY LEGAL SERVICES

THIS FORM IS TO BE USED TO REQUEST ADVICE AND/OR REPRESENTATION FROM THE DISTRICT ATTORNEY'S OFFICE REGARDING THE COUNTY OF OKLAHOMA, COUNTY OFFICIALS AND EMPLOYEES AS REQUIRED BY SECTIONS 215.4, 215.5, 215.25 AND 215.26 OF TITLE 19 OF THE OKLAHOMA STATUTES.

IF ADVICE IS SOUGHT, THE REQUEST MUST BE SIGNED BY AN ELECTED COUNTY OFFICER. THIS FORM MUST BE FILLED OUT AND SUBMITTED TO THE CIVIL DIVISION OF THE OKLAHOMA COUNTY DISTRICT ATTORNEY'S OFFICE IN A TIMELY MANNER. ALL RESPONSES TO REQUESTS FOR ADVICE WILL BE IN WRITING.

IF THE REQUEST IS FOR LEGAL REPRESENTATION UNDER 19 O. S. SECTION 215.25, THE REQUEST MUST BE SUBMITTED IN WRITING EARLY ENOUGH TO PERMIT THE DISTRICT ATTORNEY'S OFFICE ADEQUATE TIME TO COMPLETE A THOROUGH "GOOD-FAITH-AND-COURSE-OF-EMPLOYMENT" INVESTIGATION AS CONTEMPLATED BY 19 O.S. SECTION 215.26.

DATE OF REQUEST: 05/11/22

COUNTY DEPARTMENT MAKING REQUEST: Planning Commission

STATE WITH SPECIFICITY, WHAT THE REQUEST IS AND WHY THE ASSISTANCE OF THE DISTRICT ATTORNEY'S OFFICE IS NEEDED:

Review BOCC Resol 2022-1660 AS to form & legality
ReplAT in correcting SCRIVENER'S ERROR in Addressing In Addition to

ATTACH ADDITIONAL DOCUMENTS AS APPROPRIATE. (NOTE: Advice, reviews and approvals as to "form and legality" are based on the documentation and information provided to the District Attorney's Office. Please provide all relevant information when requesting an opinion or review from the District Attorney's Office).


COUNTY OFFICER

.....
DATE RECEIVED BY DISTRICT ATTORNEY: _____

REPLY BY DISTRICT ATTORNEY: _____

DAVID PRATER
DISTRICT ATTORNEY

By: _____